

FULL 12TH FLOOR  
AS-BUILT FLOOR PLAN | **CREATIVE OFFICE** | **3,000 RSF**

WORKSTATIONS: 18	OFFICE: 1	LOUNGE: 1
RECEPTION: 1	MEETING ROOM/ ADDITIONAL OFFICE: 1	CONFERENCE ROOM: 1
PANTRY: 1	BREAKOUT ROOM: 1	BATHROOMS: 2
<b>TOTAL: 21</b>		





## FULL 9TH FLOOR

### AS-BUILT FLOOR PLAN | CREATIVE OFFICE | 3,000 RSF

WORKSTATIONS: 12

BREAKOUT SPACE: 1

OFFICE: 3

RECEPTION: 1

PANTRY: 1

MEETING ROOM: 1


CONFERENCE ROOM: 1

BATHROOMS: 2

LOUNGE: 1

**TOTAL: 18**



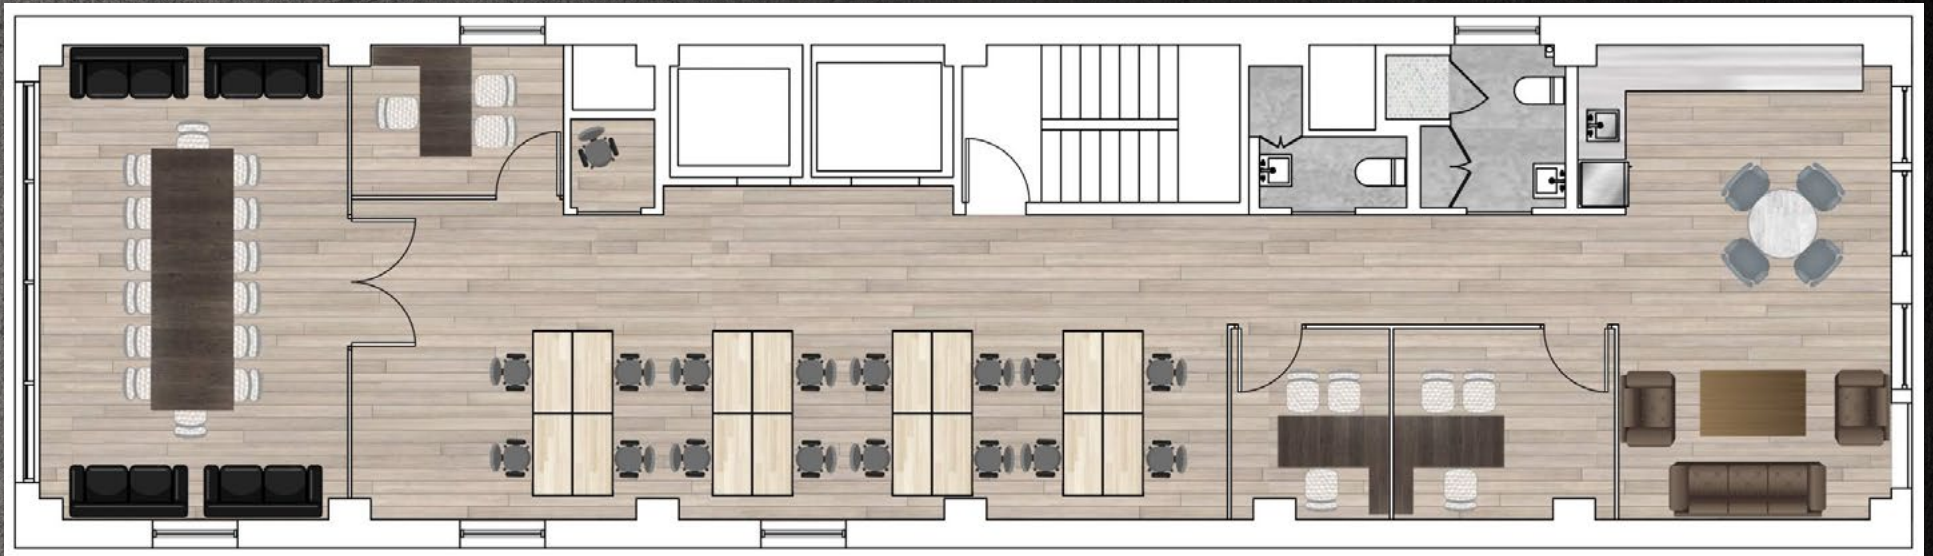

## FULL 5TH FLOOR

### AS-BUILT FLOOR PLAN | CREATIVE OFFICE | 3,000 RSF

WORKSTATIONS: 16

OFFICE: 3

LOUNGE: 1

RECEPTION: 1

MEETING ROOM/  
ADDITIONAL OFFICE: 1

CONFERENCE ROOM: 1

PANTRY: 1

BREAKOUT ROOM: 1

BATHROOMS: 2

**TOTAL: 21**





CORE + SHELL | 3,000 RSF