



AS-BUILT FLOOR PLAN | CREATIVE OFFICE | 3,000 RSF

WORKSTATIONS: 16

PANTRY: 1

MEETING ROOM: 1

CONFERENCE ROOM: 1

BATHROOMS: 2

LOUNGE: 1

BREAKOUT SPACE: 1

OFFICE: 2

TOTAL: 18



CORE + SHELL | 3,000 RSF



AS-BUILT FLOOR PLAN | CREATIVE OFFICE | 3,000 RSF

WORKSTATIONS: 12

BREAKOUT SPACE: 1

OFFICE: 3

RECEPTION: 1

PANTRY: 1


MEETING ROOM: 1

CONFERENCE ROOM: 1

BATHROOMS: 2

LOUNGE: 1

TOTAL: 18

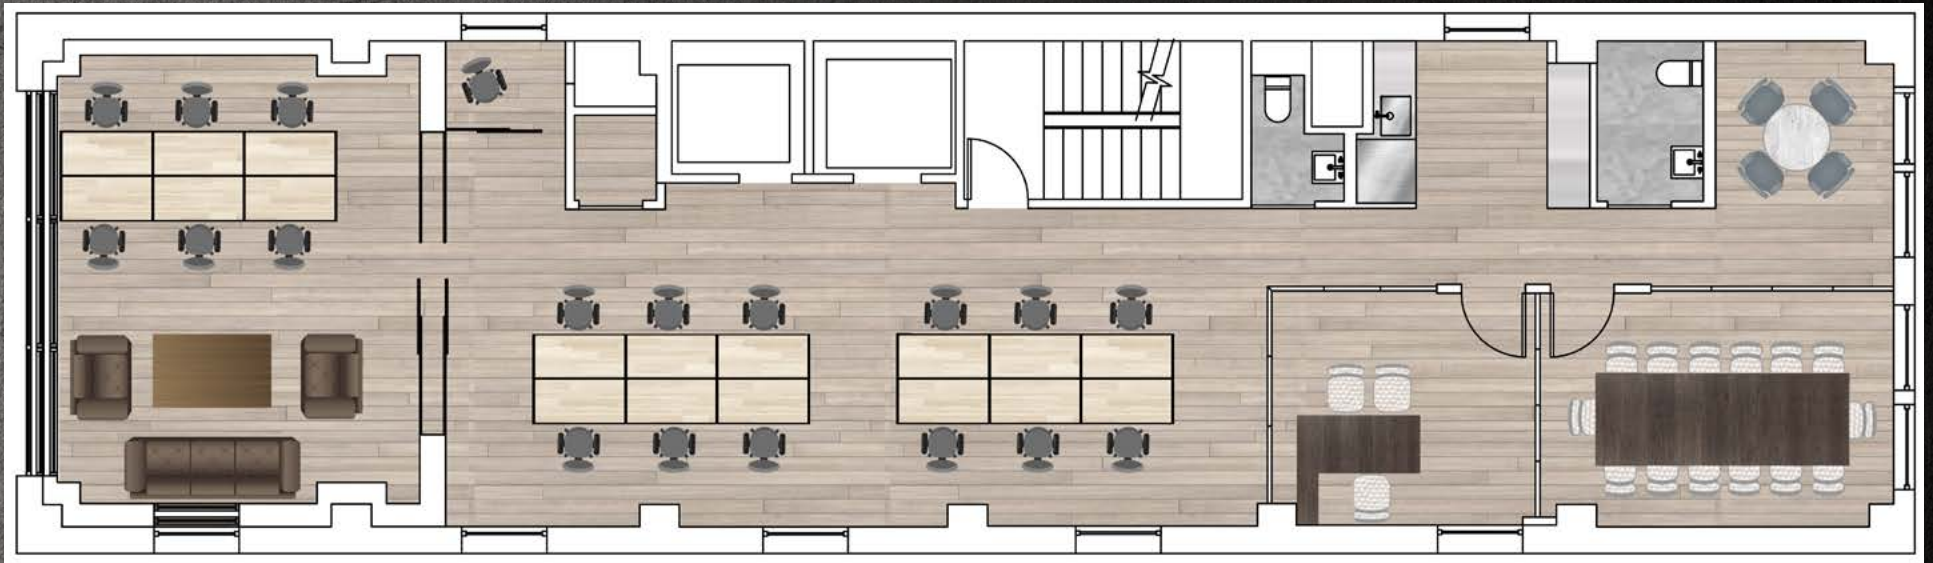

AS-BUILT FLOOR PLAN | **CREATIVE OFFICE** | **3,000 RSF**

WORKSTATIONS: 18

RECEPTION: 1

PANTRY: 1

OFFICE: 1

MEETING ROOM/
ADDITIONAL OFFICE: 1

BREAKOUT ROOM: 1

LOUNGE: 1

CONFERENCE ROOM: 1

BATHROOMS: 2

TOTAL: 21



AS-BUILT FLOOR PLAN | **CREATIVE OFFICE** | **3,000 RSF**

WORKSTATIONS: 16

BREAKOUT SPACE: 1

MEETING ROOM: 1

RECEPTION: 1

PANTRY: 2

LOUNGE: 1

CONFERENCE ROOM: 1

BATHROOMS: 2

TOTAL: 18



AS-BUILT FLOOR PLAN | **CREATIVE OFFICE** | **3,000 RSF**

WORKSTATIONS: 16

BREAKOUT SPACE: 1

MEETING ROOM: 1

RECEPTION: 1

PANTRY: 2

LOUNGE: 1

CONFERENCE ROOM: 1

BATHROOMS: 2

TOTAL: 18