

AS-BUILT FLOOR PLAN | **3,000 RSF**





## AS-BUILT FLOOR PLAN | CREATIVE OFFICE | 3,000 RSF

WORKSTATIONS: 12

BREAKOUT SPACE: 1

OFFICE: 3

RECEPTION: 1

PANTRY: 1

MEETING ROOM: 1


CONFERENCE ROOM: 1

BATHROOMS: 2

LOUNGE: 1

**TOTAL: 18**



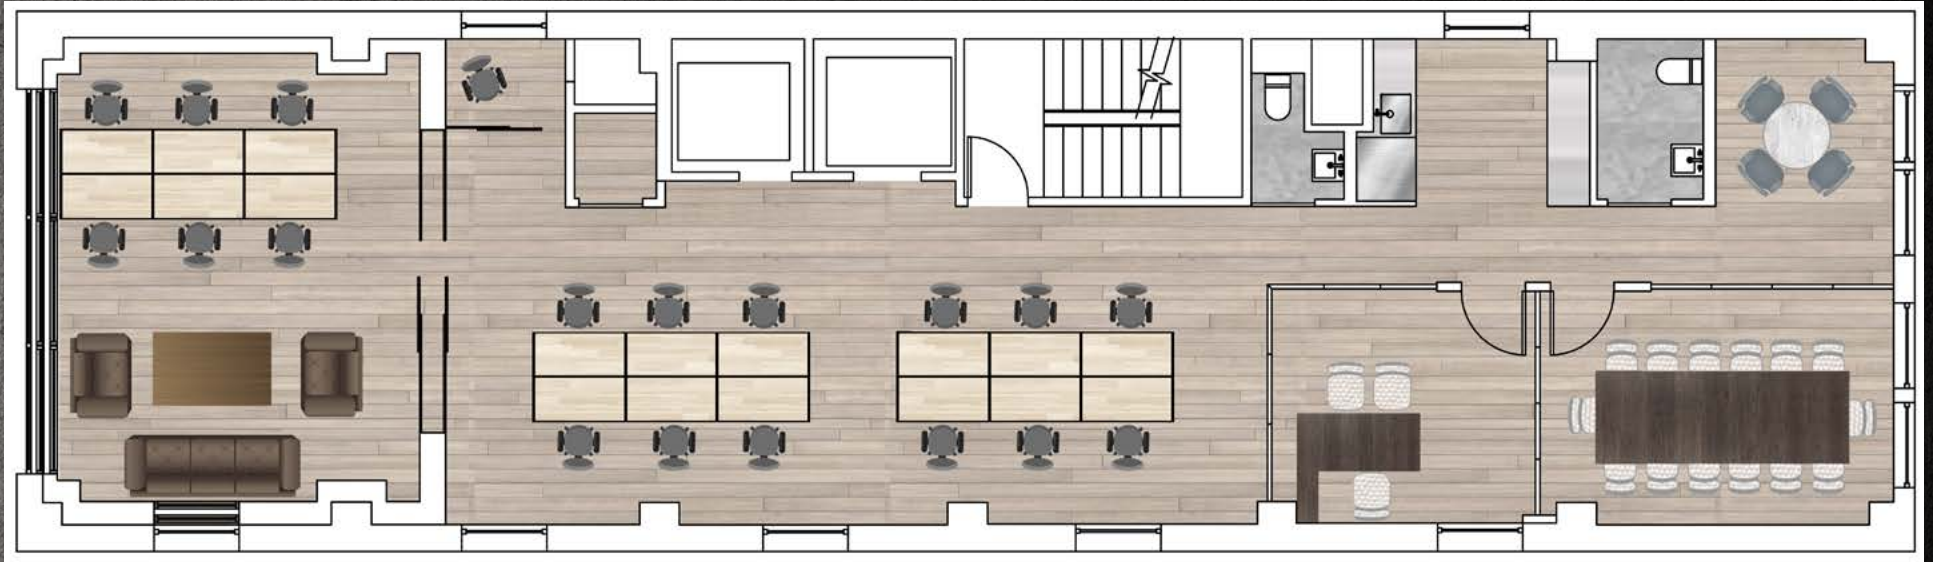

## AS-BUILT FLOOR PLAN | CREATIVE OFFICE | 3,000 RSF

WORKSTATIONS: 18

RECEPTION: 1

PANTRY: 1

OFFICE: 1

MEETING ROOM/  
ADDITIONAL OFFICE: 1

BREAKOUT ROOM: 1

LOUNGE: 1

CONFERENCE ROOM: 1

BATHROOMS: 2

**TOTAL: 21**





## AS-BUILT FLOOR PLAN | CREATIVE OFFICE | 3,000 RSF

WORKSTATIONS: 16

BREAKOUT SPACE: 1

MEETING ROOM: 1

RECEPTION: 1

PANTRY: 2

LOUNGE: 1

CONFERENCE ROOM: 1

BATHROOMS: 2

**TOTAL: 18**





## AS-BUILT FLOOR PLAN | CREATIVE OFFICE | 3,000 RSF

WORKSTATIONS: 16

BREAKOUT SPACE: 1

MEETING ROOM: 1

RECEPTION: 1

PANTRY: 2

LOUNGE: 1

CONFERENCE ROOM: 1

BATHROOMS: 2

**TOTAL: 18**