



FULL 9TH FLOOR

AS-BUILT FLOOR PLAN | CREATIVE OFFICE | 3,000 RSF

WORKSTATIONS: 12

BREAKOUT SPACE: 1

OFFICE: 3

RECEPTION: 1

PANTRY: 1


MEETING ROOM: 1

CONFERENCE ROOM: 1

BATHROOMS: 2

LOUNGE: 1

TOTAL: 18

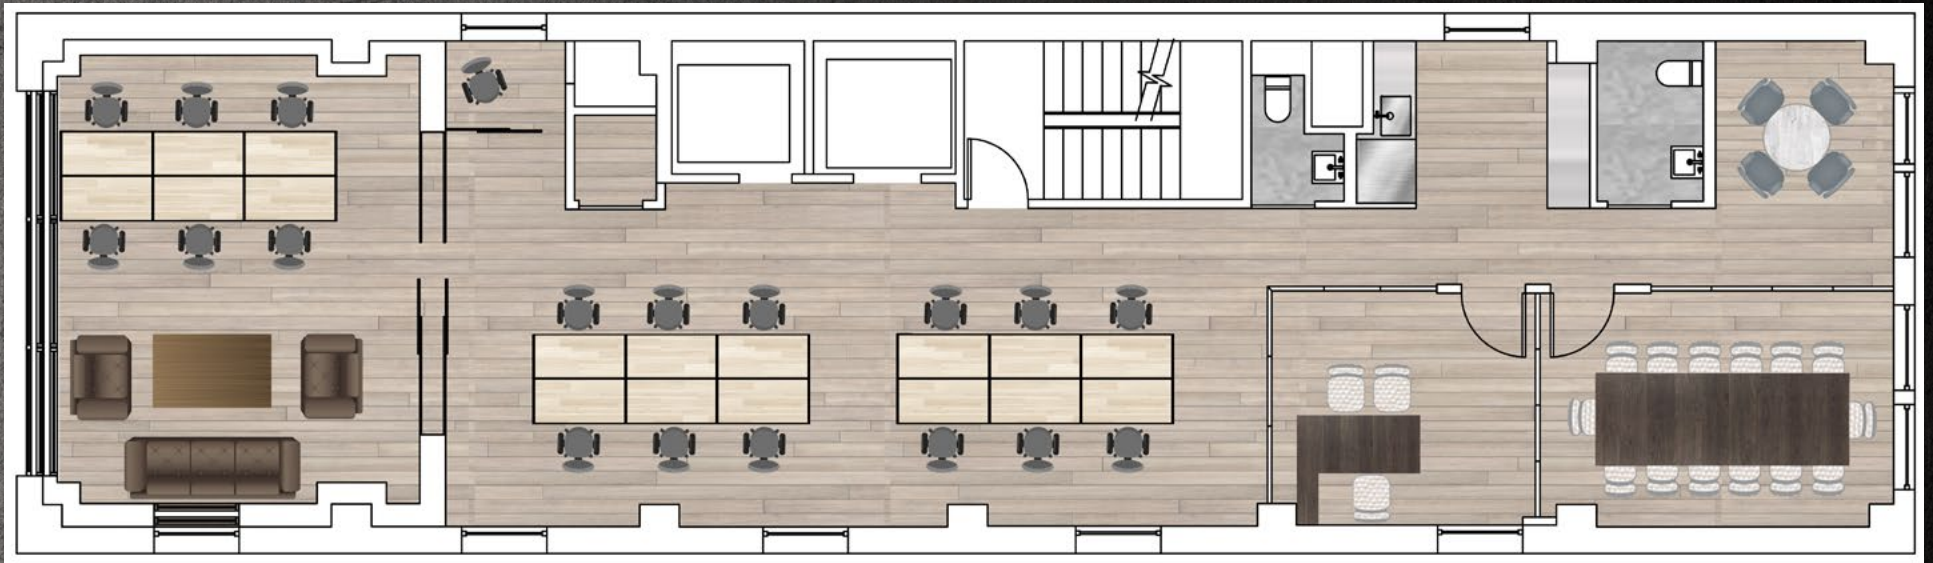

FULL 12TH FLOOR

AS-BUILT FLOOR PLAN | **CREATIVE OFFICE** | **3,000 RSF**

WORKSTATIONS: 18

RECEPTION: 1

PANTRY: 1

OFFICE: 1

MEETING ROOM/
ADDITIONAL OFFICE: 1


BREAKOUT ROOM: 1

LOUNGE: 1

CONFERENCE ROOM: 1

BATHROOMS: 2

TOTAL: 21

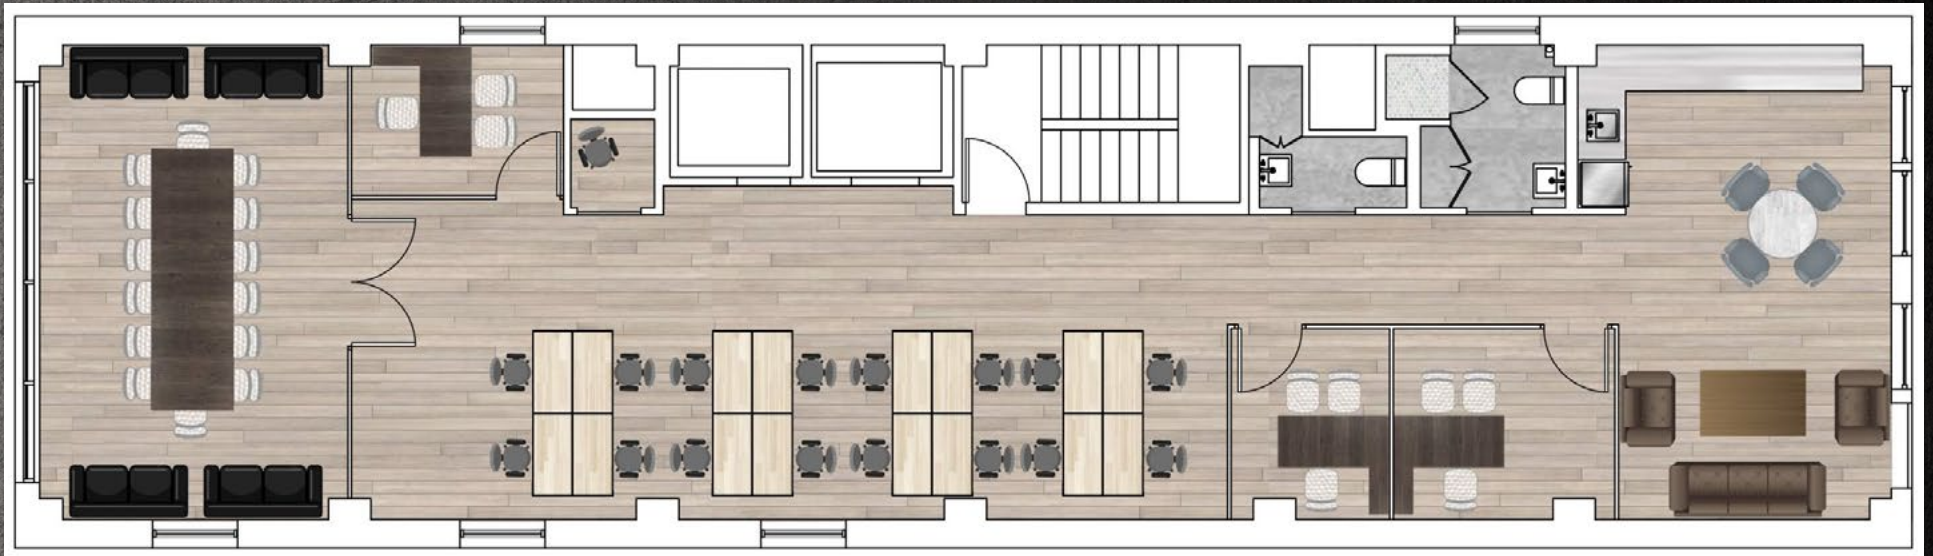

FULL 5TH FLOOR

AS-BUILT FLOOR PLAN | **CREATIVE OFFICE** | **3,000 RSF**

WORKSTATIONS: 16

OFFICE: 3

LOUNGE: 1

RECEPTION: 1

MEETING ROOM/
ADDITIONAL OFFICE: 1

CONFERENCE ROOM: 1

PANTRY: 1

BREAKOUT ROOM: 1

BATHROOMS: 2

TOTAL: 21



CORE + SHELL | 3,000 RSF