


As-Built

3,000 RSF

West 25th Street

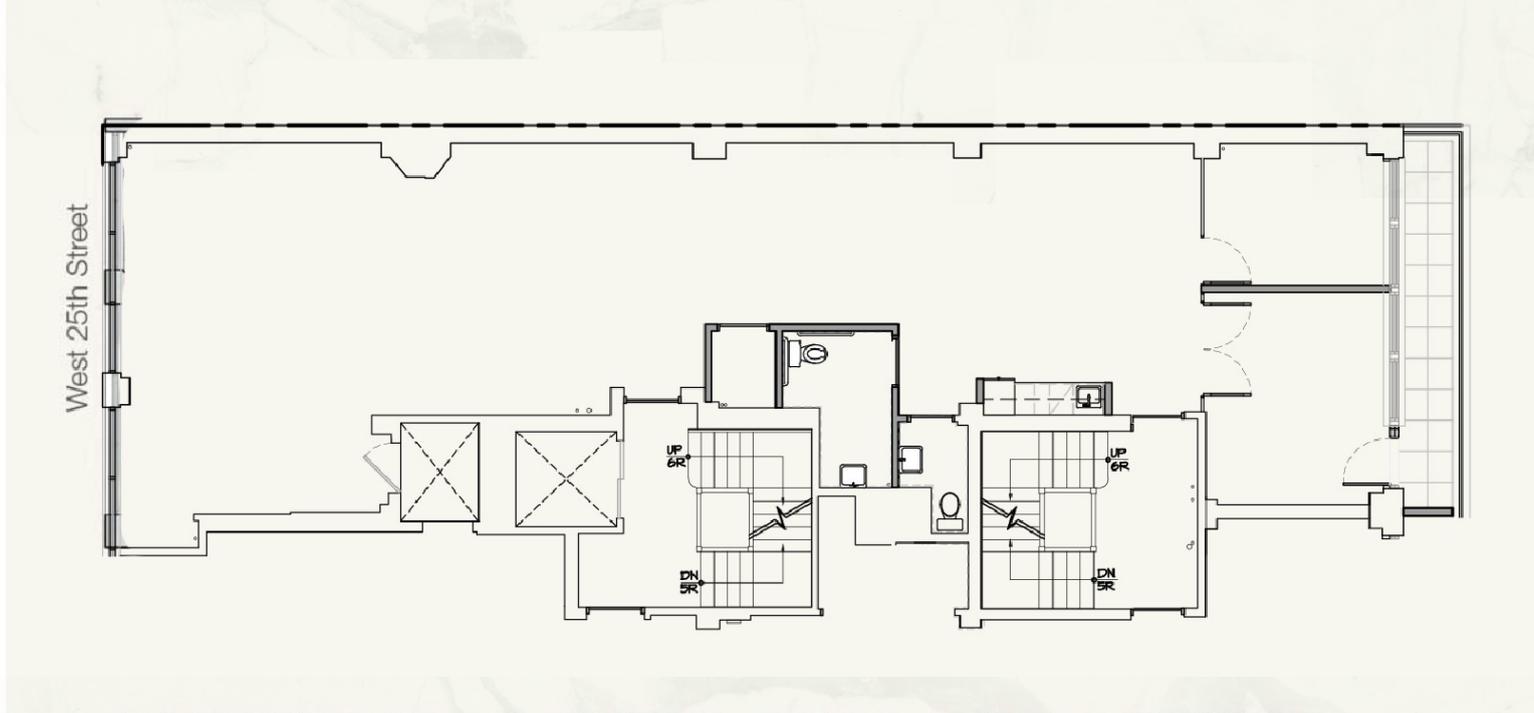

HALF FLOOR TEST FIT

3,000 RSF

West 25th Street



HALF FLOOR TEST FIT

3,000 RSF

West 25th Street

